
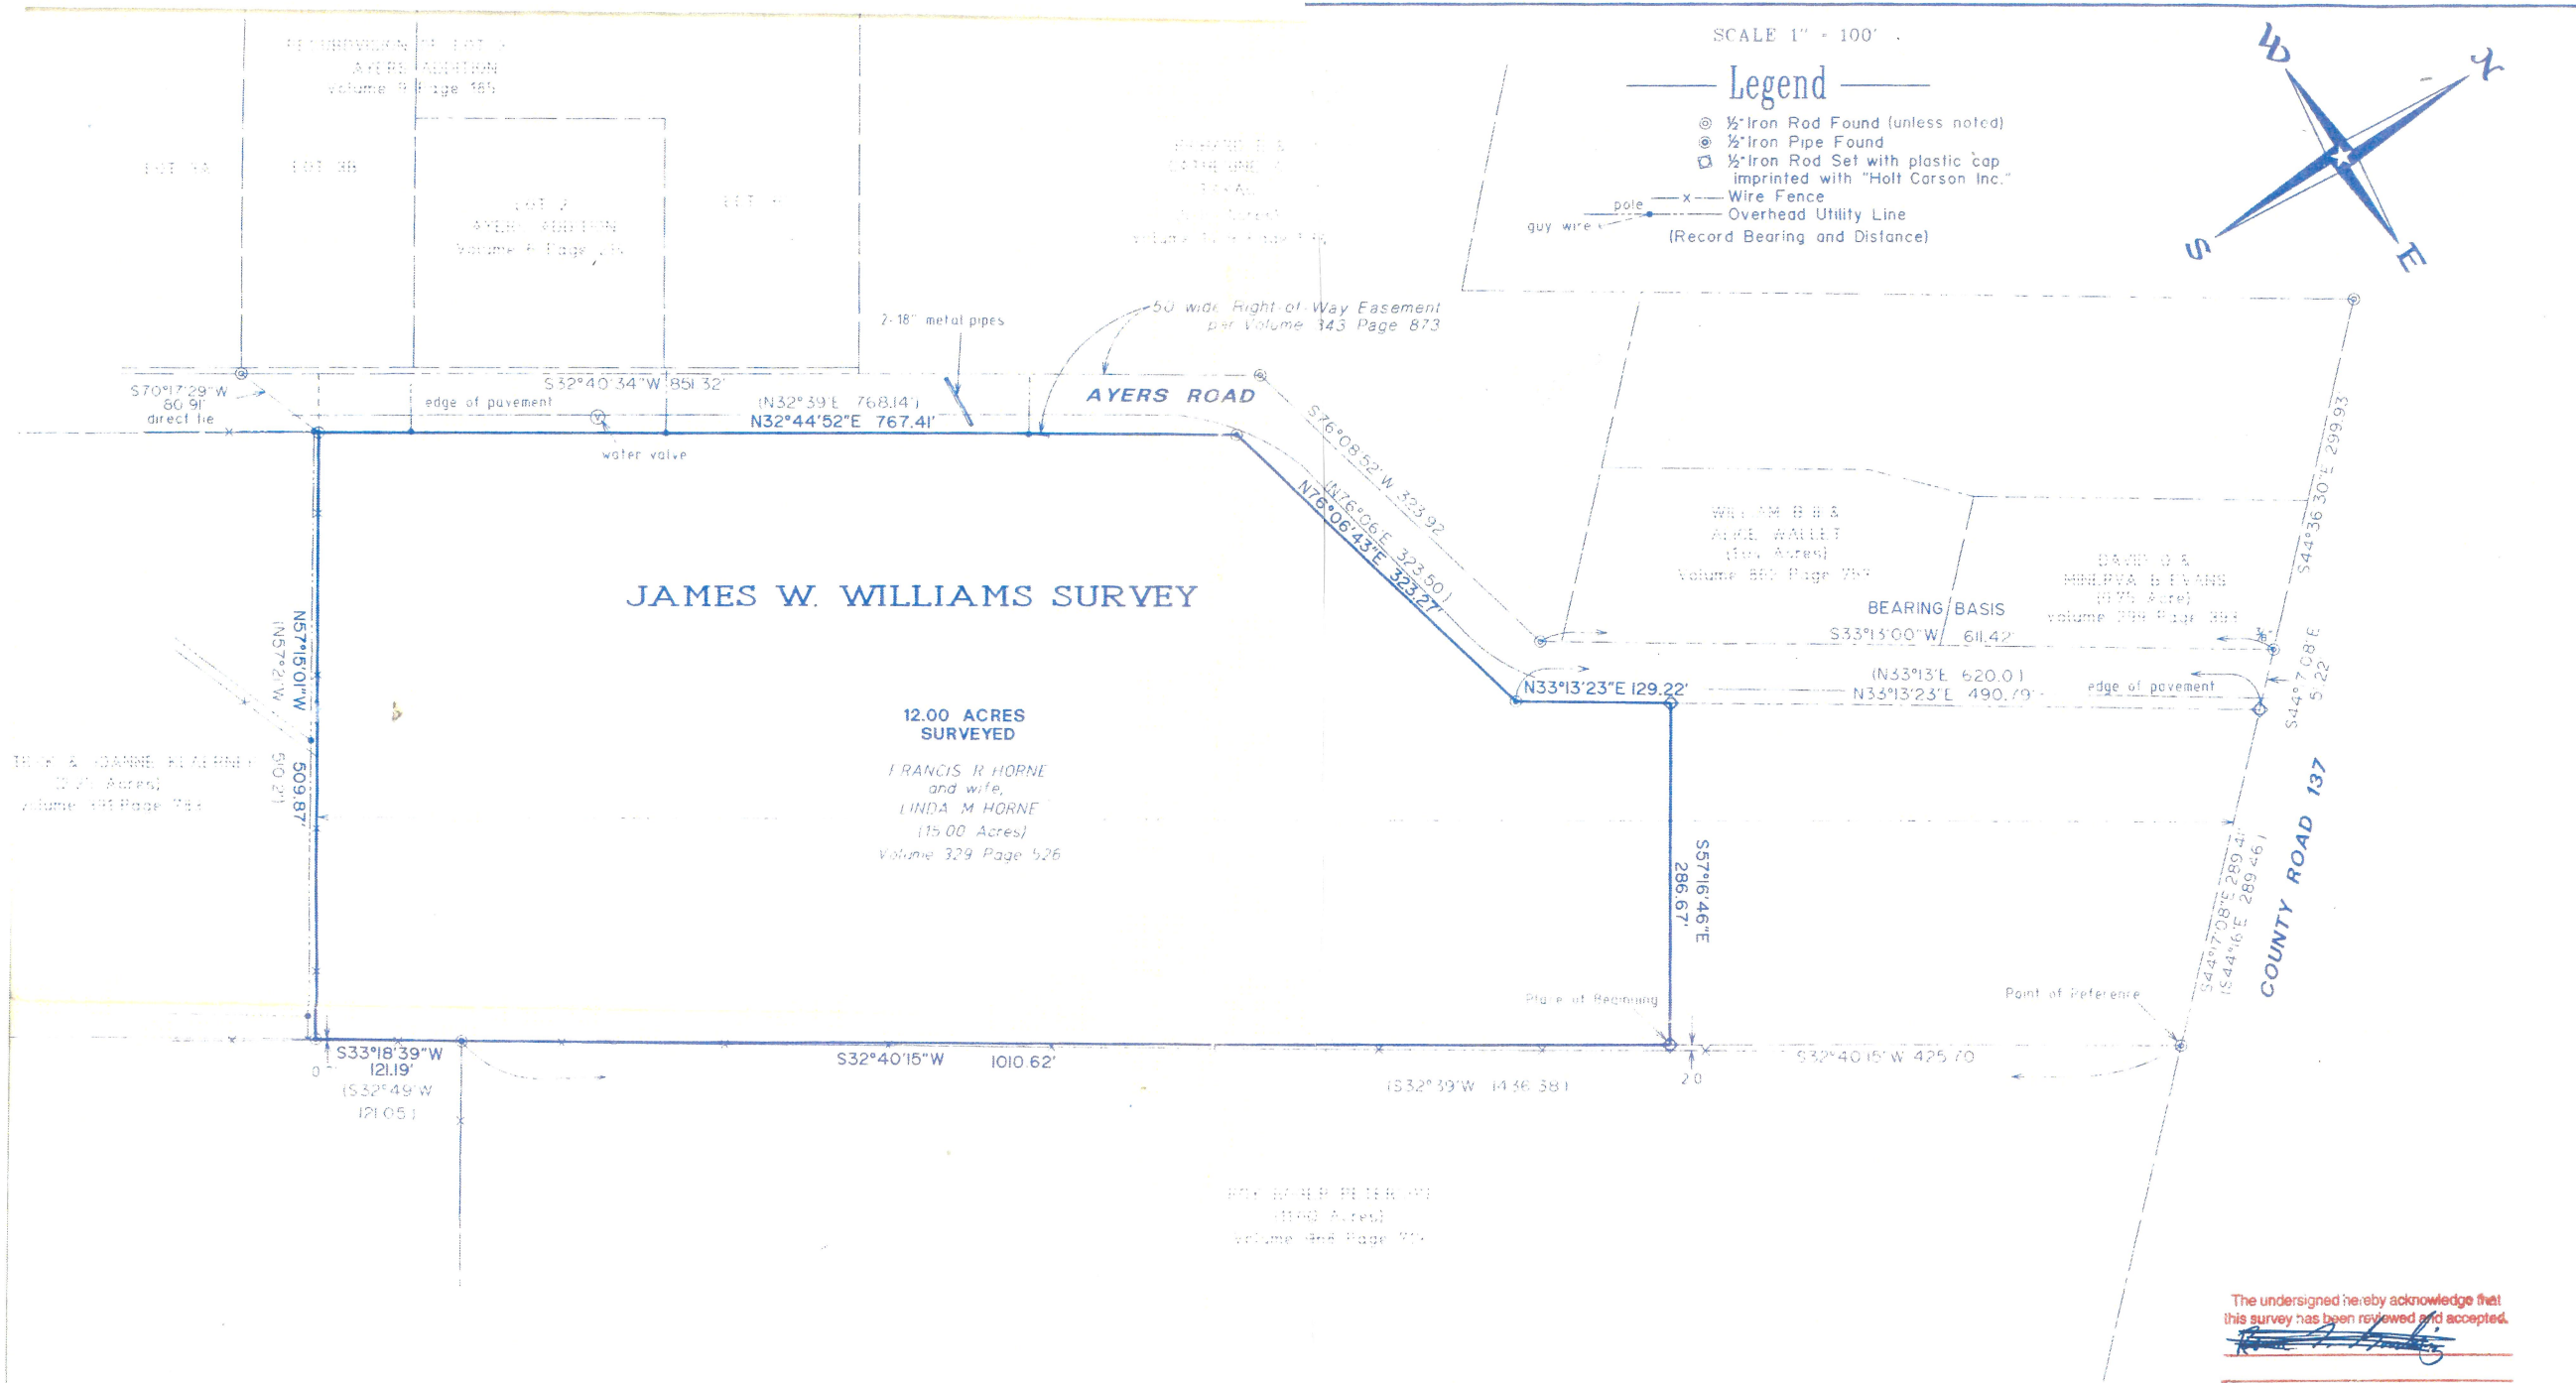


SCALE 1" = 100'

### Legend

- ⊙ 1/2" Iron Rod Found (unless noted)
- ⊙ 1/2" Iron Pipe Found
- ⊙ 1/2" Iron Rod Set with plastic cap imprinted with "Holt Carson Inc."
- x— Wire Fence
- Overhead Utility Line (Record Bearing and Distance)

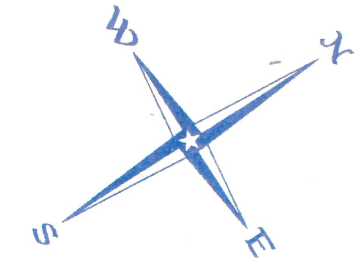

The undersigned hereby acknowledge that this survey has been reviewed and accepted.

*[Signature]*

**NOTE**  
This tract is subject to right-of-way easement for a water line and appurtenances to Goforth Water Supply Corporation as set out in Volume 470 Page 121 of the Deed Records of Hays County, Texas and described as 30 ft in width based upon on the centerline of LTR as installed.

GP No 023576SM1  
TO Ron T Gooding and Justine M Gooding  
First American Title Insurance Company  
San Marcos Title Company  
Wells Fargo Bank

**SURVEY MAP OF:**  
12.00 ACRES OF LAND BEING OUT OF THE JAMES W. WILLIAMS SURVEY, AND BEING A PORTION OF THAT CERTAIN (15.00 ACRES) OF LAND AS CONVEYED TO FRANCIS R. HORNE AND WIFE, LINDA M. HORNE BY DEED RECORDED IN VOLUME 329 PAGE 526 OF THE DEED RECORDS OF HAYS COUNTY, TEXAS LOCATED ON AYERS ROAD

See accompany field note description

THE STATE OF TEXAS  
THE COUNTY OF TRAVIS

The undersigned does hereby certify that a survey was this day made on the ground of the property legally described hereon and is accurate to the best of my abilities and that there are no boundary line conflicts, encroachments, shortages in area, overlapping of improvements, visible utility lines, or roads in place, except as shown hereon, and said property abuts a dedicated roadway.

This property is within Zone X (areas determined to be outside of the 100 Year Flood Plain) according to the Federal Emergency Management Agency Flood Insurance Rate Map Panel No 4803210185 E dated February 18 1998.

DONE the 29th day of SEPTEMBER, A.D. 2006

BY *[Signature]*  
Holt Carson  
Registered Professional Land Surveyor No 5166  
HOLT CARSON INC  
1904 Fairview Road Austin, Texas 78704  
(512) 442-0990